IN RE: PETITION FOR ZONING VARIANCE SW/S Heather Hill Lane, approx. ZONING COMMISSIONER 750' NW of Falls Road 1517 Heather Hill Lane * OF BALTIMORE COUNTY 8th Election District * CASE #91-214-A 3rd Councilmanic District Terrell R. Johnson, et al Legal Owner Jeffrey H. Hidgon, et al Contract Purchaser *****

ORDER OF DISMISSAL

The Petitioners herein requested a Petition for a Zoning Variance from Section 1A04.3.B.3 Building setbacks to provide for a 38 ft. side yard setback in lieu of the required 50 ft. setback on the south side of the dwelling; a variance from Section 1A04.3.B.3 to legitimize an existing side yard setback of 46 ft. in lieu of the required 50 ft. on the northside of the dwelling; a zoning variance from Section 400.1 to legitimize the location of an existing accessory structure (pool) in the side yard in lieu of the required rear yard and to amend the Final Development Plan of "Heather Hill" lot No. 10, as more particularly described on Petitioner's Exhibit

WHEREAS, the above captioned case was scheduled for hearing before the Zoning Commissioner on February 22, 1991; and,

WHEREAS, the Contract Purchasers, through their attorney, Lawrence E. Schmidt, Esquire, sent a letter dated February 19, 1991 requesting that the above captioned matter be withdrawn as the present owner does not desire to pursue the variances.

> 1517 Heather Hill Lane continuation sheet

and the architectural style of the dwelling require that the addition be constructed on the south side of the dwelling. Construction of the addition would result in a side yard setback of 38 feet in lieu of the required 50 feet.

The Petitioners also desire to legitimize an existing side yard setback on the north side of the dwelling. The subject dwelling, which was built in excess of three years ago, was constructed so as to leave a side yard setback on the northern side of 46 feet. The Petitioners desire no new construction, merely the legitimization of the existing setback as it relates to the location of the dwelling on the lot.

Further, the Petitioners seek relief from Section 400.1 of the Baltimore County Zoning Regulations. If the addition as proposed is approved, its construction will result in the placement of the existing in-ground pool in the side yard of the lot in lieu of its present location in the rear yard. In that the pool is existing, and in view of the proposed location of the addition, a variance from Section 400.1 of the BCZR is requested.

Further, the Petitioners request an amendment of the final development plan of "Heather Hill"; specifically for lot 10 therein, so as to allow construction outside of the building envelope of a residence.

The Petitioners assert that all variances are needed in view of the existing locations of the dwelling and accessory structure (pool), as well as the configuration of the lot and agricultural traits of the dwelling.

IT IS THEREFORE ORDERED by the Zoning Commissioner for Baltimore Counday of tolanar 1991 that the Petition for Zoning Variance, in the above captioned case be and the same is hereby DISMISSED without prejudice.

> ZONING COMMISSIONER OF BALTIMORE COUNTY

cc: Peoples Counsel

AFFIDAVIT IN SUPPORT OF RESIDENTIAL ZONING VARIANCE

•

The undersigned hereby affirms under the penalties of perjury to the Zoning Commissioner Baltimore County, as follows: That the information herein given is within the personal knowledge of the Affiant(s) and Affiant(s)

is/are competent to testify thereto in the event that a public hearing is scheduled in the future with regard thereto.

That the Affiant(s) does/do presently or upon settlement will reside at ______ 1517 Heather Hill Lane, Cockeysville, MD 21030

That based upon personal knowledge, the following are the facts upon which I/we base the request for for a Residential Zoning Variance at the above address: (indicate hardship or practical difficulty) In order to consummate the sale of the property to the contract purchasers and permit them to build an addition

to the dwelling for an in-law apartment. The location of the dwelling on the lot, the dwelling's configuration and architecture, all require that the addition be constructed as proposed. That Affiant(s) acknowledge(s) that if protest is filed, Affiant(s) will be required to pay a exosting and advertising fee and may be required to provide additional information.

Jan Satte JEFFRE F. HIGDEN MARIES PATIT MARY JUHIGDON

AFFIANT (Handwritten Signature) Terrell R. Johnson William G. Anderson AFFIANT (Printed Name)

STATE OF HARYLAND, COUNTY OF BALTIMORE, to wit:

I HEREBY CERTIFY, this 28 5 day of None who Notary Public of the State of Maryland, in and for the County aforesaid, personally appeared TErrell P. Johnson i Joseph T. Hartman

the Affiant(s) herein, personally known or satisfactorily identified to me as such Affiant(s), and made oath in due form of law that the matters and facts hereinabove set forth are true and correct to the best of his/her/their knowledge and belief.

AS WITNESS my hand and Notarial Seal.

NOTARIAL SEAL ANGELA C. HUDSON, Notary Public

STATE OF MARYLAND, COUNTY OF BALTIMORE, TO WIT:

I HEREBY CERTIFY that on this 29th day of NOVEMBER, 1990, before me, the subscriber, a Notary Public of the State of Maryland, personally appeared, JEFFREY F. HIGDON, MARY JO HIGDON and MARIE S. PATTI, the nts herein, known to me (or satisfactorily proven) to be the persons names are subscribed to the within instrument, and acknowledged that ecuted the same for the purposes therein contained and in my signed and sealed the same.

AS WITNESS MY HAND AND NOTARIAL SE ommission Engines SEPT. 1, 1991

Baltimore County Government Zoning Commissioner Office of Planning and Zoning *********

111 West Chesapeake Avenue Towson, MD 21204

887-3353

February 25, 1991

Lawrence E. Schmidt, Esquire 606 Baltimore Avenue, Suite 301 Towson, Maryland 21204

> RE: Case No. 91-214-A Petition for Zoning Variance

Attached hereto is an Order of Dismissal regarding the above captioned matter.

> Very truly yours, J. Robert Haines Zoning Commissioner

JRH:mmn

cc: Peoples Counsel

Corporation (hereinaliter called COMMONWEA... and the undersigned number of the parties shall hold in trust for the benefit COMMONWEALTH such real property now or the said Trustees shall hold in trust for the benefit commonwealth such real property now or the said Trustees shall hold in trust for the benefit commonwealth such real property now or the said Trustees shall hold in trust for the benefit shall be said Trustees shall hold in trust for the benefit shall be said Trustees shall hold in trust for the benefit shall be said Trustees shall hold in trust for the benefit shall be said Trustees shall hold in trust for the benefit shall be said Trustees shall hold in trust for the benefit shall be said Trustees shall hold in trust for the benefit shall be said Trustees shall hold in trust for the benefit shall be said Trustees shall hold in trust for the benefit shall be said Trustees shall hold in trust for the benefit shall be said Trustees shall hold in trust for the benefit shall be said Trustees shall hold in trust for the benefit shall be said Trustees shall (1) The TRUSTEES shall hold such real property conveyed to them in accordance with the terms of this Agreement and so TRUSTEES

trip trip and a second property conveyed to train a second with the second property and shall exercise all the reunder in trust for the uses and purposes established under certain programs administered by COMMONWEALTH, and shall exercise all of the duties and obligations may, from time to time exist. (2) The TRUSTEES shall have the power to convey, mortgage, borrow, pledge, lease, exchange, give options for sales and leases, invest, distribute and to take any and all other action with respect to such property and proceeds thereof in accordance with their powers and duties as TRUSTEES. No person acting as TRUSTEE hereunder shall be required to enter security or to post bond for the faithful performance of his

(3) Any two of the TRUSTEES hereinbelow named, may act for and on behalf of all TRUSTEES and exercise all of the rights and powers enumerated herein. Any instrument, conveyance, mortgage, lease or agreement made on behalf of the TRUSTEES by any two of them reciting enumerated networking instrument, conveyance, mortgage, mass or agreement made on behalf or the TROSTEES of any New Orthographs and the TRUSTEES, That such TRUSTEES are authorized to act in accordance with the terms hereof, as to any person or corporation dealing with such TRUSTEES, shall be binding upon all of the TRUSTEES and upon COMMONWEALTH without any duty on the part of any such person or corporation to inquire into the authority of such TRUSTEES.

(4) TRUSTEES are hereby relieved of any and all personal liability for any act of omission, misfeasance or malfeasance, in connection with or in the exercise of their duties and/or obligations, provided; however, that nothing contained herein shall relieve any or all of the said

TRUSTEES from liability for any act of fraud. (5) The President of COMMONWEALTH shall, at any time, have the power to remove any or all of the said TRUSTEES, with or without cause, accept the resignations of any or all of the said TRUSTEES, and may appoint one or more successor TRUSTEES. A written instrument cause, accept the resignations of any of an of the same recorded among the same records wherein this Agreement shall evidencing such action by the President of COMMONWEALTH and filed or recorded among the same records wherein this Agreement shall be found of record shall be conclusive evidence of the action of the said President of COMMONWEALTH under this provision.

(6) This Trust shall terminate twenty (20) years from the day and year first above written. If any real or personal property remains in this trust twenty (20) years from the day and year first above written, title to all such property shall be conveyed by said TRUSTEES TO COMMON-WEALTH or such other person or entity as COMMONWEALTH shall designate. IN WITNESS WHEREOF, the parties hereto have caused these presents to be executed the day and year first above written, intending

COMMONWEALTH RELOCATION SERVICES, INC.

STATE OF PENNSYLVANIA: COUNTY OF PHILADELPHIA:

On this 1st day of August, 1985, before me appeared William G. Walsh, Jr., to me personally known, who, being by me duly swom, did say that he is the President of Commonwealth Relocation Services, Inc., and that said Instrument was executed on behalf of said corporation by authority of its board of directors and said William G. Walsh, Jr., acknowledged said instrument to be the free act and deed of said corporation.

IN WITNESS WHEREOF, I hereunto set my hand and official seal.

STATE OF PENNSYLVANIA: COUNTY OF PHILADELPHIA:

thereby to bind themselves, their successors and assigns.

On this 1st day of August, 1985, before me personally appeared Terrell R. Johnson, Joseph T. Hartman, George E. McCarty, William G. Anderson and George J. Egner to me known to be the persons who executed the foregoing instrument and acknowledged that they executed IN WITNESS WHEREOF, I hereunto set my hand and seal.

Certified to be a true and correct copy of the original. Commonwealth Relocation Services, Inc.

Notary Public Phile, Phile Co

My Commission Expires June 27, 1988

CATHERINE M BOLAND

Notary Public, Phila, Phila, Co.

My Commission Expires June 27, 1988

PÉTITION FOR RESIDENTIAL VARIANCE

TO THE ZONING COMMISSIONER OF BALTIMORE COUNTY:

Contract Purchaser: Jeffrey F. Higdon

Mary Jo Higdon, & Marie S. Patti

1/ La many 10 thopan

606 Baltimore Ave., Suite 301

8511 Tallwood Road

Attorney for Petitioner:

Towson, MD 21204

Attorney's telephone number

City/State/Zip Code

(Type or Print Name)

Lutherville, MD 21093

Lawrence E. Schmidt

The undersigned, legal owner(s) of the property situate in Baltimore County and which is described in the description and plat attached hereto and made a part hereof, petition for a Variance from Section 1A04.3 B. 3. Building Setbacks - To provide for a 38 foot side yard setback in lieu of the required 50 foot setback on the south side of the dwelling; from IAO4.3 B. 3., to legitimize an existing side yard setback of 46 feet in lieu of the required 50 feet on the north side of the dwelling; from 400.1 to legitimize the location of an existing accessory structure (pool) in the side yard in lieu of the required rear yard.

IND TO MEND THE FINAL DELVLOSMONT PLAN OF "HEATIGHT HILL" FOR LOT of the Zoning Regulations of Baltimore County, to the Zoning Law of Baltimore County, for the following reason: (indicate hardship or practical difficulty)

In order to build an addition to the dwelling which the petitioners have contracted to purchase. The contract purchasers desire to construct an addition to accomodate an in-law apartment. One of the purchasers of the property is the mother-in-law and mother of the other petitioners. The location of the existing dwelling on the lot, the configuration of the lot

Property is to be advertised and/or posted as prescribed by Zoning Regulations. (See attached for I, or we, agree to pay expenses of the above Variance posting and, if necessary, advertising, upon filing of this petition, and further agree to and are to be bound by the zoning regulations and restrictions of Baltimore County adopted pursuant to the Zoning Law for Baltimore County.

> I/We do solemnly declare and affirm, under the penalties of perjury, that I/we are the legal owner(s) of the property which is the subject of

STATE TOTAL STATE OF THE STATE	
Legal Owner(s): ФSEPH Т.НА Terrell R. Johnson, William	RTMAN G. Andersc
(Type or Print Name) Trustees under Declaration	ionE
Signature	WHO IN WHITE
of Trust dated August 1, 19 [Wype of Print Name]	5
I fluxed R. Thus	10
Signature Jupat T- Harb	200 BF
Address	Etaphone
City/State/Zin Code	pe 75

Name, address and phone number of legal owner, contract purchaser or representative to be contacted. Lawrence E. Schmidt

Name Suite 301 606 Baltimore Avenue 823-3300 Address Towson, MD 21204

ONDERED by the Zoning Commissioner of Baltimore County, this jj day of νv_i , 19 2o, that the subject matter of this patition be posted on the property on or before the 1990 day of 1990

A PUBLIC HEARING HAVING BEEN REQUESTED AND/OR FOUND TO BE REQUIRED.

(301) 823-3300

IT IS FURTHER DROERED by the Zoning Commissioner of Baltimore County, this _____ day of _____, 19___, that the subject mattar of this petition be advertised, as required by the Zoning Law of Baltimore County, in two newspapers of general circulation throughout Baltimore County, that the property be reposted, and that the public hearing be had before the Zonling Commissioner of Baltimore County in Room 108, County Office Building in Towson, Baltimore County, on the _____ day of _____, 19___, at ____ o'clock,

Description of 1517 Heather Hill Lane

Beginning at that point on the Southwest side of Heather Hill Lane, a roadway 50 feet wide, at a distance of 750 feet (±) northwest of the intersection of Falls Road and Heather Hill

All that lot of ground situate in Baltimore County, Maryland and described as follows: BEING KNOWN AND DESIGNATED AS lot No. 10, as shown on a Plat entitled "Plat of Heather Hill", which Plat is recorded among the Land Records of Baltimore County in Plat Book E.H.K. Jr. No. 55, Folio 32. The improvements thereon being known as No. 1517 Heather Hill Lane.

CERTIFICATE OF POSTING ZONING DEPARTMENT OF BALTIMORE COUNTY Toursen, Maryland

District & T/2.	Date of Posting Electricis 17, 1990.
D. 1. 1. 1. 9/12	ill Lane, 150' MM of Falls Road.
Lever Wasther Kile Fine	
Location of Signs: In front of 15	
Remarks: Posted by	Date of return: December 10 1996

91-214-1 CERTIFICATE OF POSTING ZONING DEPARTMENT OF BALTIMORE COUNTY

and the second second

887-3353

num & the	Date of Posting January 29, 1991
Posted for: Variance	
	on et al
Petitioner: Sw/5 Heathur Lil	a Lane Expande 750' SW
Location of property: SW/5 Heather Lieb of Falls Road 1517 Head Location of Signs: In front of 1517	Ther Hill Lane
y was 1517	Hather Heil Jane
Location of Signs: 132 4	
Remarks:	Date of return: February 1, 1991
Posted by S. J. Grata Signature	Data of Feturi.
Number of Signs:	

Baltimore County Government Zoning Commissioner Office of Planning and Zoning

111 West Chesapeake Avenue Towson, MD 21204

January 14, 1991

NOTICE OF HEARING

The Zoning Commissioner of Baltimore County, by authority of the Zoning Act and Regulations of Baltimore County will hold a public hearing on the property identified herein in Room 106 of the County Office Building, located at 111 W. Chesapeake Avenue in Towson, Maryland 21204 as follows:

Case Number: 91-214-A SW/S Heather Hill Lane, approx. 750' NW of Falls Road 1517 Heather Hill Lane 8th Election District - 3rd Councilmanic Legal Owner(s): Terrell R. Johnson, et al Contract Purchaser(s): Jeffrey H. Hidgon, et al HEARING: FRIDAY, FEBRUARY 22, 1991 at 10:00 a.m.

Variance to provide for a 38 ft. side yard setback in lieu of required 50 ft. setback on the south side of the dwelling; to legitimize an existing side yard setback of 46 ft. in lieu of the required 50 ft. on the north side of the dwelling; to legitimize the location of an existing accessory structure (pool) in the side yard in lieu of the required rear yard, and to amend the Final Development Plan of "Heather Hill" for lot 10.

J. ROBERT HAINES Zoning Commissioner of Baltimore County

cc: Jeffrey F. Higdon, et al Lawrence E. Schmidt, Esq. CERTIFICATE OF PUBLICATION

THIS IS TO CERTIFY, that the annexed advertisement was published in THE JEFFERSONIAN, a weekly newspaper published in Towson, Baltimore County, Md., once in each of _____ successive weeks, the first publication appearing on 1 - 94, 19 9.

THE JEFFERSONIAN,

The Zoning Commissioner of Beltimore County, by authority of the Zoning Act and Regulations of Baltimore County will hold a public hearing on the property identified herein in Room 106 of the County Office Building, located at 111 W. Chesapeake Avenue in Towson, Maryland 21204 et Infliws: Case number: 91-214-A SW/S Heather Hill Lane, ap-prox. 750' NW of Falls Road 1517 Heather Hill Lane 8th Election District 3rd Councilmanic Legal Owner(s): Contract Purchaser(s): Jeffrey H. Hidgon, et al Hearing Date: Friday, Feb. 22, 1991 at 10:00 a.m. Variance: to provide for a 38 ft. side yard setback in lieu of re-quired 50 ft. setback on the south side of the dwelling; to legitimize an existing side yard setback of 46 ft. in lieu of the required 50 ft.

on the north side of the dwelling to legitimize the location of an existing accessory structure (pool) in the side yard in lieu of the required rear yard, and to amend the Final Development Plan of "Heather Hill" for lot 10.

T/J/1/281 Jan. 24.

J. ROBERT HAINES

NOTICE OF HEARING

NOTICE OF HEARING

Case number: 91-214-A SW/S Heather Hill Lane, ap-prox. 750' NW of Falls Road 1517 Heather Hill Lane 8th Election District

Legai Owner(s): Terreil R. Johnson, et al

Contract Purchaser(s): Jeffrey H. Hidgon, et al Hearing Date: Friday, Feb. 22, 1991 at 10:00 a.m.

Variance: to provide for a 38 ft. side yard setback in fieu of required 50 ft. setback on the south side of the dwelling; to legitimize an existing side yard setback of 46 ft. in lieu of the required 50 ft. on the noru; side of the dwelling; to legitimize the location of an existing accessory structure (pool) in the side yard in lieu of the remained pear yard, and to amend

quired rear yard, and to amend the Final Development Plan of "Heather Hill" for lot 10.

CERTIFICATE OF PUBLICATION

THIS IS TO CERTIFY, that the annexed advertisement was published in TOWSON TIMES, a weekly newspaper published in Towson, Baltimore County, Md., once in each of _____ successive weeks, the first publication appearing on 1-24, 19 91.

5. Zete Olm

Baltimore County Government Zoning Commissioner Office of Planning and Zoning

111 West Chesapeake Avenue Towson, MD 21204

887-3353

January 31, 1990

Lawrence E. Schmidt, Esquire 606 Baltimore AVenue, Suite 301 Towson, MD 21204

RE: Item No. 224, Case No. 91-214-A Petitioner: Terrell R. Johnson, et al Petition for Residential Variance

Dear Mr. Schmidt:

The Zoning Plans Advisory Committee has reviewed the plans submitted with the above referenced petition. The following comments are not intended to indicate the appropriateness of the zoning action requested, but to assure that all parties are made aware of plans or problems with regard to the development plans that may have a bearing on this case. Director of Planning may file a written report with the Zoning Commissioner with recommendations as to the suitability of the requested zoning.

Enclosed are all comments submitted from the members of the Committee at this time that offer or request information on your petition. If similar comments from the remaining members are received, I will forward them to you. Otherwise, any comment that is not informative will be placed in the hearing file. This petition was accepted for filing on the date of the enclosed filing certificate and a hearing scheduled accordingly.

IT WOULD BE APPRECIATED IF YOU WOULD RETURN YOUR WRITTEN COMMENTS TO MY OFFICE, ATTENTION JULIE WINIARSKI. IF YOU HAVE ANY QUESTIONS REGARDING THIS, PLEASE CONTACT HER AT 887-3391.

-very truly yours, JAMES E. DYER Zoning Plans Advisory Committee

JED:jw

Enclosures

cc: Mr. Jeffrey F. Higdon 8511 Tallwood Road Lutherville, MD 21093

Baltimore County Government Zoning Commissioner Office of Planning and Zoning

111 West Chesapeake Avenue Towson, MD 21204

887-3353

DATE: 2 5 91

Jeffrey F. Hidgon, et al 8511 Tallwood Road Lutherville, MD 21093

SW/S Heather Hill Lane, approx. 750' NW of Falls Road 1517 Heather Hill Lane 8th Election District - 3rd Councilmanic Legal Owner(s): Terrell R. Johnson, et al Contract Purchaser(s): Jeffrey H. Hidgon, et al HEARING: FRIDAY, FEBRUARY 22, 1991 at 10:00 a.m.

Dear Petitioner(s):

Please be advised that $\frac{131.77}{}$ is due for advertising and posting of the above

THIS FEE MUST BE PAID AND THE ZONING SIGN & POST SET(S) RETURNED ON THE DAY OF THE HEARING OR THE ORDER SHALL NOT ISSUE. DO NOT REMOVE THE SIGN & POST SET(S) FROM THE PROPERTY UNTIL THE DAY OF THE

Please make your check payable to Baltimore County, Maryland. Bring the check and the sign & post set(s) to the Zoning Office, County Office Building, 111 W. Chesapeake Avenue, Room 113, Towson, Maryland fifteen (15) minutes before your hearing is scheduled to begin.

J. ROBERT HAINES ZONING COMMISSIONER BALTIMORE COUNTY, MARYLAND

cc: Lawrence E. Schmidt, Esq.

111 West Chesapeake Avenue

Towson, MD 21204

Jeffrey F. Higdon, et al

Lutherville, Maryland 21093

Re: CASE NUMBER: 91-214-A

8511 Tallwood Road

Baltimore County Government Zoning Commissioner Office of Planning and Zoning

111 West Chesapeake Avenue Towson, MD 21204

887-3353

Your petition has been received and accepted for filing this 23rd day of November, 1990.

ZONING COMMISSIONER

Petitioner: Terrell R. Johnson, et al Petitioner's Attorney: Lawrence E. Shcmidt

BALTIMORE COUNTY, MARYLAND

INTER-OFFICE CORRESPONDENCE

J. Robert Haines

DATE: December 17, 1990 Zoning Commissioner

Pat Keller, Deputy Director

Office of Planning and Zoning SUBJECT: Caves Valley Club, Inc., Item No. 167

Caves Valley Club, Inc., Item No. 168 Dianna Lynn Peterson, Item No. 192 Charles F. Hohman, Item No. 213 Russell F. Morris, III, Item No. 218 Laura E. Earles, Item No. 220 Herbert Balzanna, Item No. 221 Terrell R. Johnson, Joseph Hartman, Trustees, Item No. 224 V Michael Robert Snowman, Item No. 225 Herbert J. Scism, Item No. 226 James Stabler, Item No. 232 Douglas A. Pooley, Item No. 233

In reference to the above-listed cases, staff offers no comments.

If there should be any further questions or if this office can provide additional information, please contact Jeffrey Long in the Office of Planning at 887-3211.

PK/JL/cmm NCITEMS/ZAC1

Dear Petitioner(s): Please be advised that your Petition for Residential Zoning Variance has been assigned the above case number. Any contact made to this office should reference the case number. This letter also serves as a refresher regarding the administrative process.

LOCATION: SW/S Heather Hill Lane, 750'(+/-) NW of Falls Road

1517 Heather Hill Lane

Baltimore County Government

Zoning Commissioner Office of Planning and Zoning

December 13, 1990

1) Your property will be posted on or before December 19, 1990. The last date (closing date) on which a neighbor may file a formal request for hearing is January 3, 1991. Should such request be filed, you will receive notification that the matter will not be handled through the administrative process. This will mean advertising of the public hearing and reposting of the property. The public hearing will be scheduled approximately 30 - 45 days from receipt of said notice. In either case, (a) receipt of notification that you will have a public hearing or, (b) the passing of the closing date, the sign and post can then be removed from the property and returned to this office. Failure to return the sign and post will cause your Order to be held and incur a \$50.00 charge. Please to advised that the Order will not be available for you to pick-up the day you return the sign.

2) Assuming no neighbor has requested a public hearing, the file now enters the final review stage of the administrative process. The Zoning Commissioner must now decide whether to grant or deny the request. He also has the option to request a public hearing.

> 3) PLEASE UNDERSTAND THAT ON THE DATE AFTER THE POSTING PERIOD, THE PROCESS IS NOT COMPLETE. THE FILE MUST GO THROUGH FINAL REVIEW AND THE DECISION MAKING PROCESS. WHEN THE ORDER IS READY IT WILL BE FORWARDED TO YOU VIA FIRST CLASS MAIL. ORDERS ARE NOT AVAILABLE FOR DISTRIBUTION PRIOR TO BEING MAILED TO YOU.

12/19/90

Baltimore County Fire Department 700 East Joppa Road, Suite 901 Towson, Maryland 21204-5500 (301) 887-4500

Paul H. Reincke

DECEMBER 13, 1990

J. Robert Haines Zoning Commissioner Office of Planning and Zoning Baltimore County Office Building Towson, MD 21204

TERRELL R. JOHNSON AND JOSEFH T.

RE: Property Owner: HARTMAN

#1537 HEATHER HILL LANE Location:

Zoning Agenda: DECEMBER 26, 1990 Item No.:

Gentlemen:

Pursuant to your request, the referenced property has been surveyed by this Bureau and the comments below are applicable and required to be corrected or incorporated into the final plans for the property.

5. The buildings and structures existing or proposed on the site shall comply with all applicable requirements of the National Fire Protection Association Standard No. 101 "Life Safety Code", 1988 edition prior to occupancy.

REVIEWER: Ceft bout Kelly 12-14-90 Approved Catanil Brack Planning Group

Noted and

Approved Fire Prevention Bureau Kil Special Inspection Division

JK/KEK

Dennis F. Rasmussen County Executive

EALTIMORE COUNTY. MARYLAND

INTER-OFFICE CORRESPONDENCE DECEMBER 19, 1990

12/31/90

J. ROBERT HAINES, ZONING COMMISSIONER, DEPARTMENT ZONING

CHARLES E. BURNHAM, PLANS REVIEW CHIEF, DEPARTMENT OF PERMITS & LICENSES

> ZONING ITEM #: 224 PROPERTY OWNER: Terrell R. Johnson & Joseph T. Hartman, Trustees under Declaration of Trust dated 8/1/85 Contract Purchaser: Jeffrey F. Higdon & Mary Jo Higdon & Mary LOCATION:SW/S Heather Hill La, 750'(+/-) NW of Jo Higdon Falls Road (#1517 Heather Hill Lane) FIECTION DISTRICT: 8th

A REVIEW OF THE SITE PLAN FOR THE ABOVE ZONING ITEM INDICATES THE FOLLOWING:

COUNCILMANIC DISTRICT: 3rd

() PROPOSED SITE PLAN DOES, DOES NOT, COMPLY TO STATE CODE OF MARYLAND REGULATION 05.01.07, MARYLAND BUILDING CODE FOR THE HANDICAPPED.

() PARKING LOCATION () NUMBER PARKING SPACES () BUILDING ACCESS

() CURB CUTS () SIGNAGE

() RAMPS (degree slope)

() PLAN DOES, DOES NOT COMPLY TO SET BACKS FOR EXTERIOR FIRE SEPARATION DISTANCE OF ARTICLE 5 AND ARTICLE 9 OF THE CURRENT BALTIMORE COUNTY BUILDING CODE.

A BUILDING PERMIT IS REQUIRED BEFORE ANY CONSTRUCTION CAN BEGIN. SECTION 111.1 OF ARTICLE 1. CONSTRUCTION DRAWINGS

() A CHANGE OF OCCUPANCY PERMIT IS REQUIRED TO CHANGE THE EXISTING USE OF THE STRUCTURE TO THE PROPOSED USE. SEE ARTICLE THREE AND ARTICLE ONE, SECTION 103.2 ALTERATIONS MAY BE NECESSARY BY CODE TO COMPLY TO NEW USE REQUIREMENTS.

() STRUCTURE IS SUBJECT TO FLOOD PLAIN LIMITATIONS, SECTION 516.0 COUNCIL BILL #158-88 (BALTIMORE COUNTY BUILDING CODE).

() OTHER -

PERMITS MAY BE APPLIED FOR @ ROOM 100, 111 WEST CHESAPEAKE AVENUE, TOWSON, MARYLAND 21204 - PHONE - 887-3900.

THIS REVIEW COVERS ONLY MAJOR ITEMS ASSOCIATED WITH THE SITE PLAN, A FULL REVIEW MAY BE CONDUCTED WHEN THE PERMIT APPLICATION AND PLANS ARE

APPLICABLE CODE: 1987 NATIONAL BUILDING CODES AS ADOPTED BY COUNCIL BILL #158-88

CALTIMORE COUNTY, MARYLAND INTEROFFICE COFFESFORDENCE

TO: Zoning Advisory Committee DATE: December 18, 1990

The Developers Engineering Divicion has reviewed

RWB:s

EROM: Robert W. Bowling, P.E.

RE: Zoning Advisory Committee Meeting for December 36, 1990

the subject sening items and we have no comments for Items 213, 221, 224, 225, 226, 230, and 233.

For Items 187, 188, 231 and 232, the previous County Review Group comments are applicable.

Developers Engineering Division

CASE #: 91-214-A

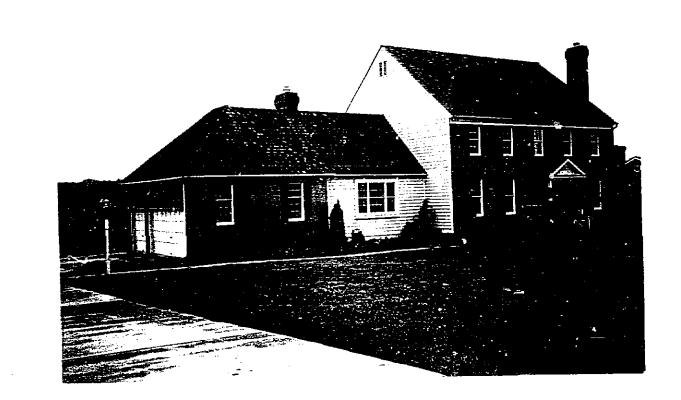




EXHIBIT # PETITIONER'S

CASE#: 91-214-A

Baltimore County Government Department of Public Works

Bureau of Traffic Engineering

The Bureau of Traffic Engineering has no comments for items number 167, 213, 221, 224, 225, 226, amd 233.

January 11, 1991

Very truly yours,

Rahee J. Famili Traffic Engineer II

Kapie of Family

887-3554 Fax 887-5784

91-214-A

401 Bosley Avenue Suite 405

Mr. J. Robert Haines

Zoning Commissioner

Dear Mr. Haines:

RJF/lvd

County Office Building

Towson, Maryland 21204

Towson, MD 21204





PETITIONER'S EXHIBIT #

BALTIMORE COUNTY, MARYLAND Inter-Office Memorandum

DATE: January 11, 1991

Robert Hain

SUBJECT: Case #91-214-A Please set this case in for a hearing and notify the Petitioners. See me if you have any questions regarding same.

Thank you.

LAWRENCE E. SCHMIDT

WHITE, PAGE & LENTZ ATTORNEYS AT LAW 606 BALTIMORE AVENUE SUITE 301 TOWSON, MARYLAND 21204 (301) 823 - 3300

GEORGE M WHITE 1891-1952 WILLIAM LENTZ 1892-1963 CHARLES G. PAGE 1902-1985

Dear Commissioner Haines:

Kindly withdraw the Petition for Variances for the above matter scheduled for hearing on February 22, 1991. Kindly be advised that the contract purchaser has withdrawn from the contract and the present owner does not desire to pursue the variances.

Lawrence E. Schmidt

LES/dps

ZONING OFFICE

FAX (301) 494-1910 February 19, 1991 J. Robert Haines, Esquire Zoning Commissioner Office of Planning and Zoning 111 W. Chesapeake Avenue Towson, MD 21204 Re: Case Number: 91-214A 1517 Heather Hill Lane

CASE #: 91-214-A







PETITIONER'S EXHIBIT #

CASE #: 91-214-A



PETITIONER'S EXHIBIT #

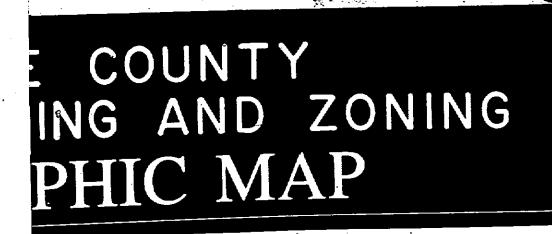

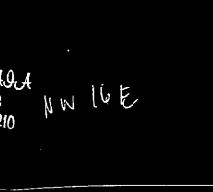

SCALE


I" = 200' ±

BEAVER DAM RUN

DATE
OF
PHOTOGRAPHY RIDGE ROAD

JANUARY
1986



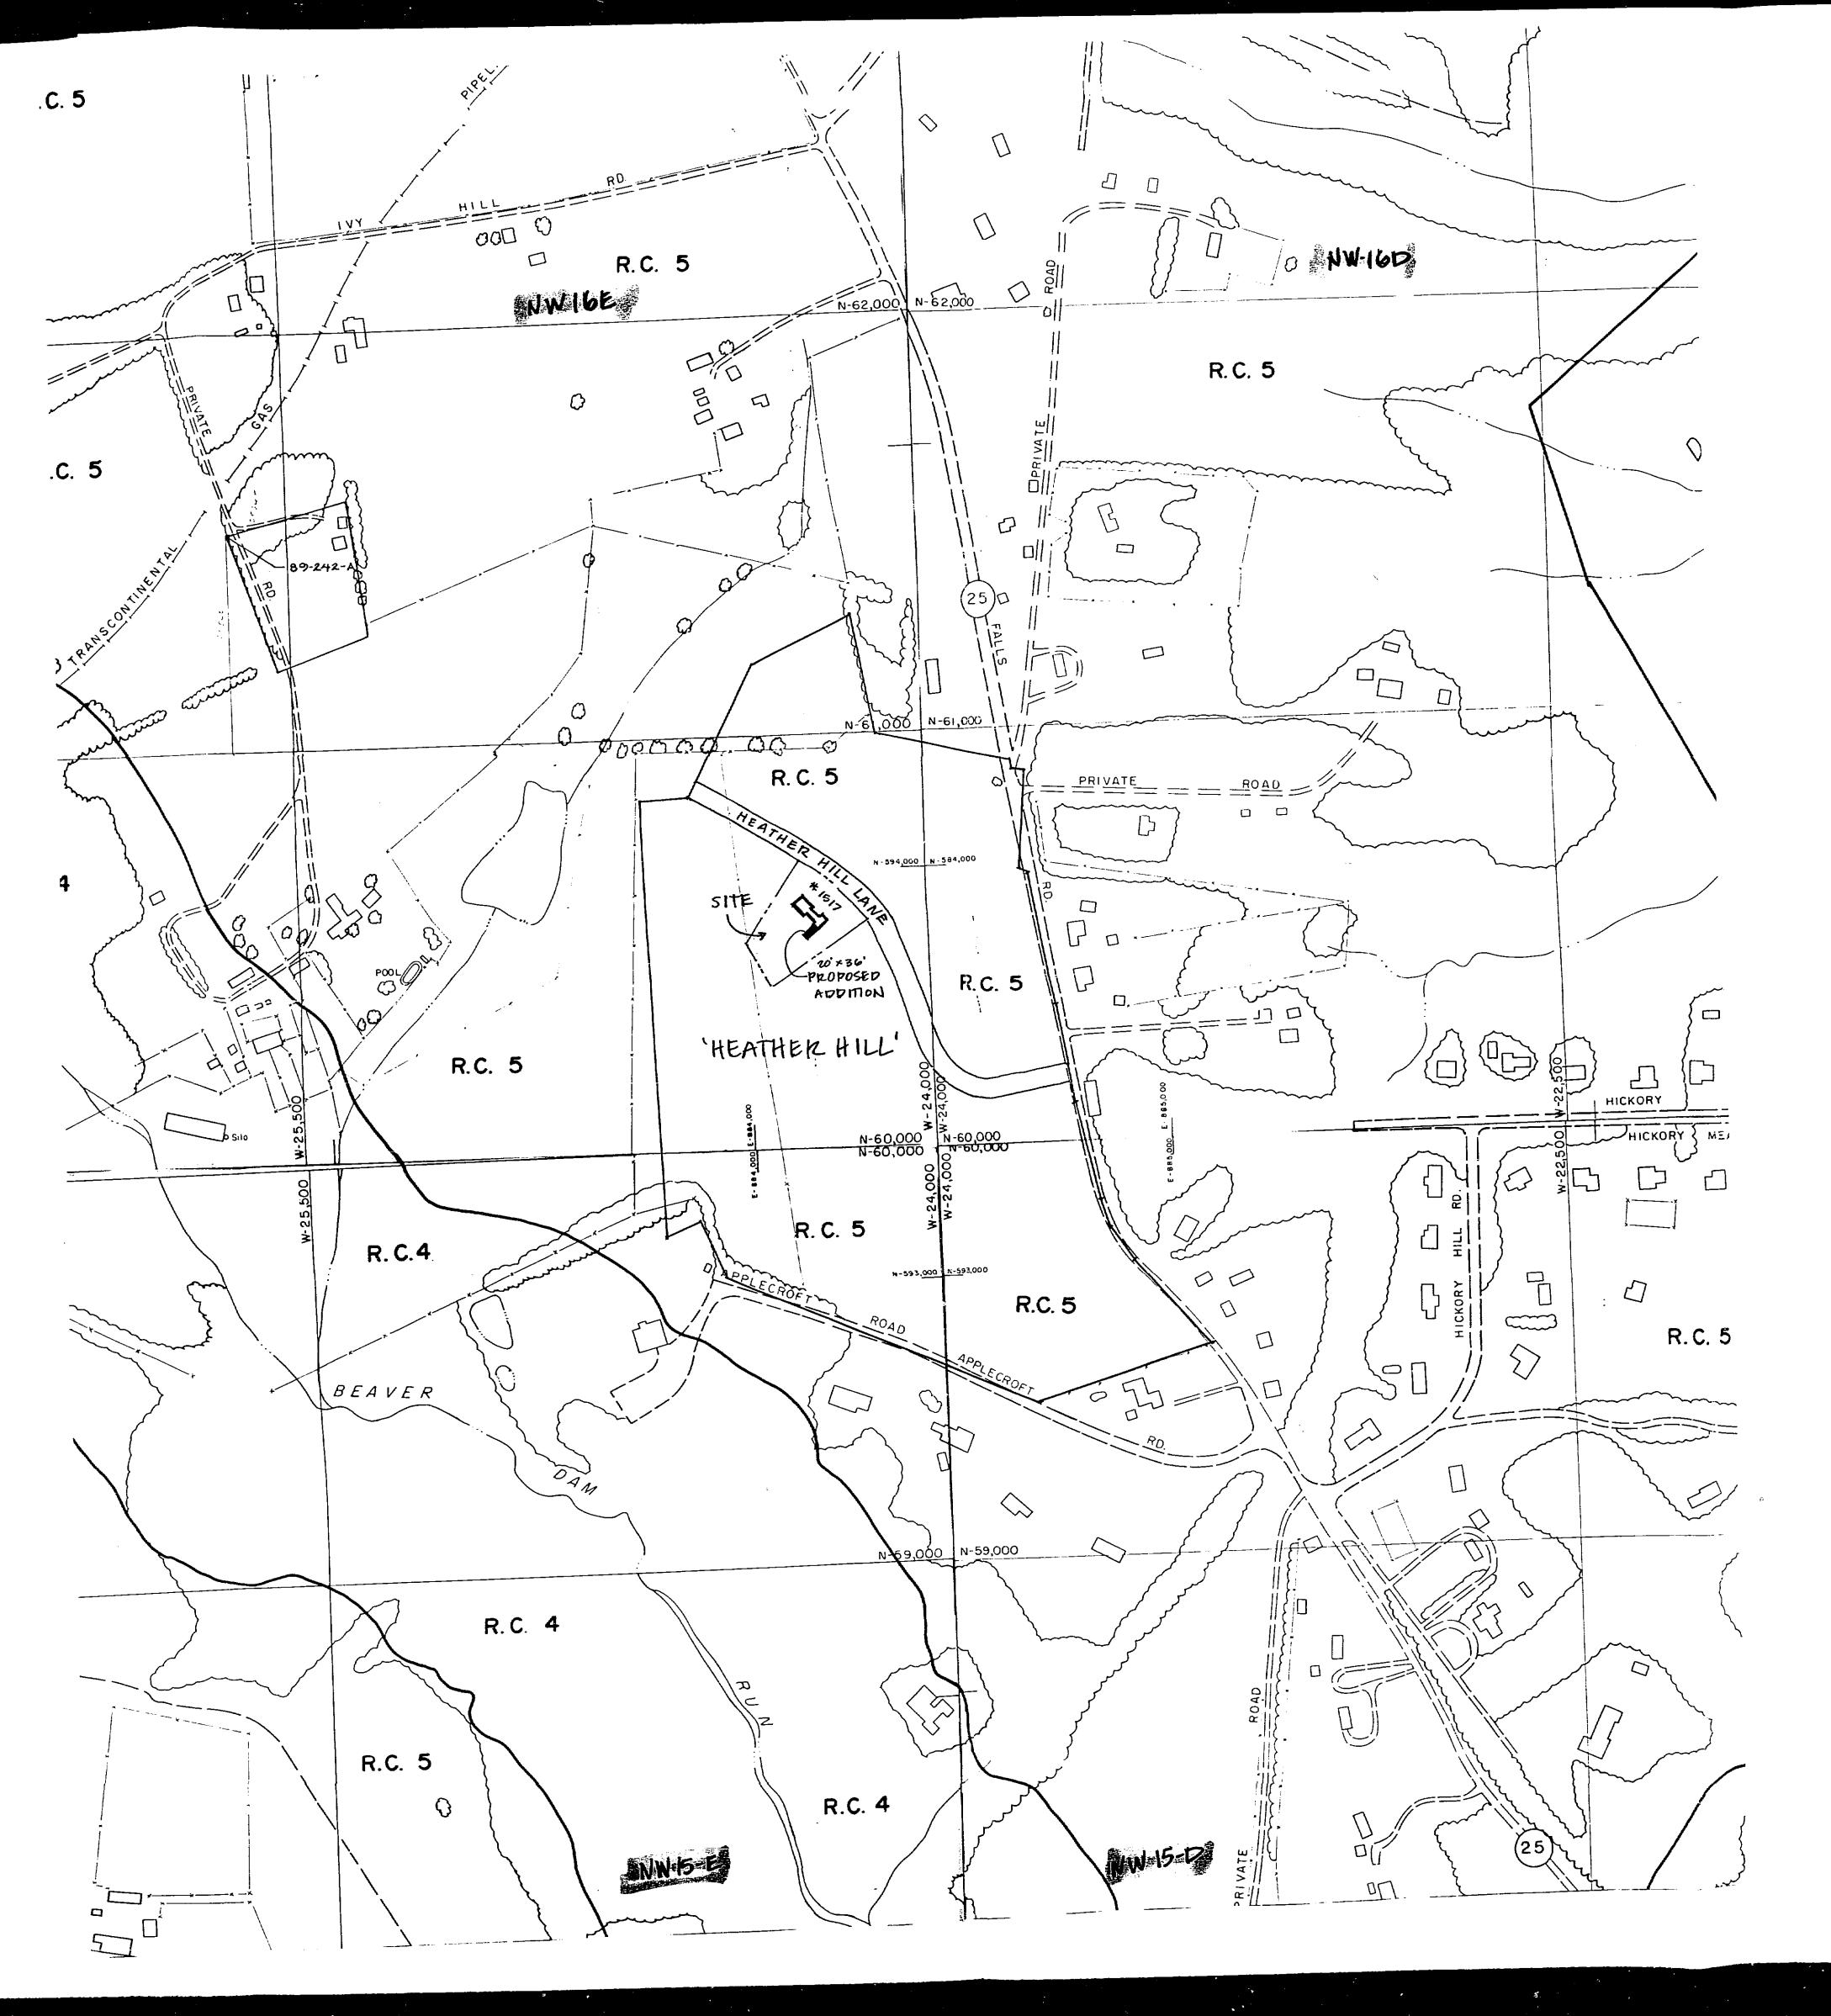

91-214-4



HIGDON RESIDENCE 1517 HEATHER HILL LANE VARIANCE REQUEST


BALTIMORE COUNTY

ZONING MAP

SCALE: 1"-200'

OBTAINED 9/12/90

Paul J. Gorman, A.J.A P. O. Box 16213 Baltimore, Md. 21210

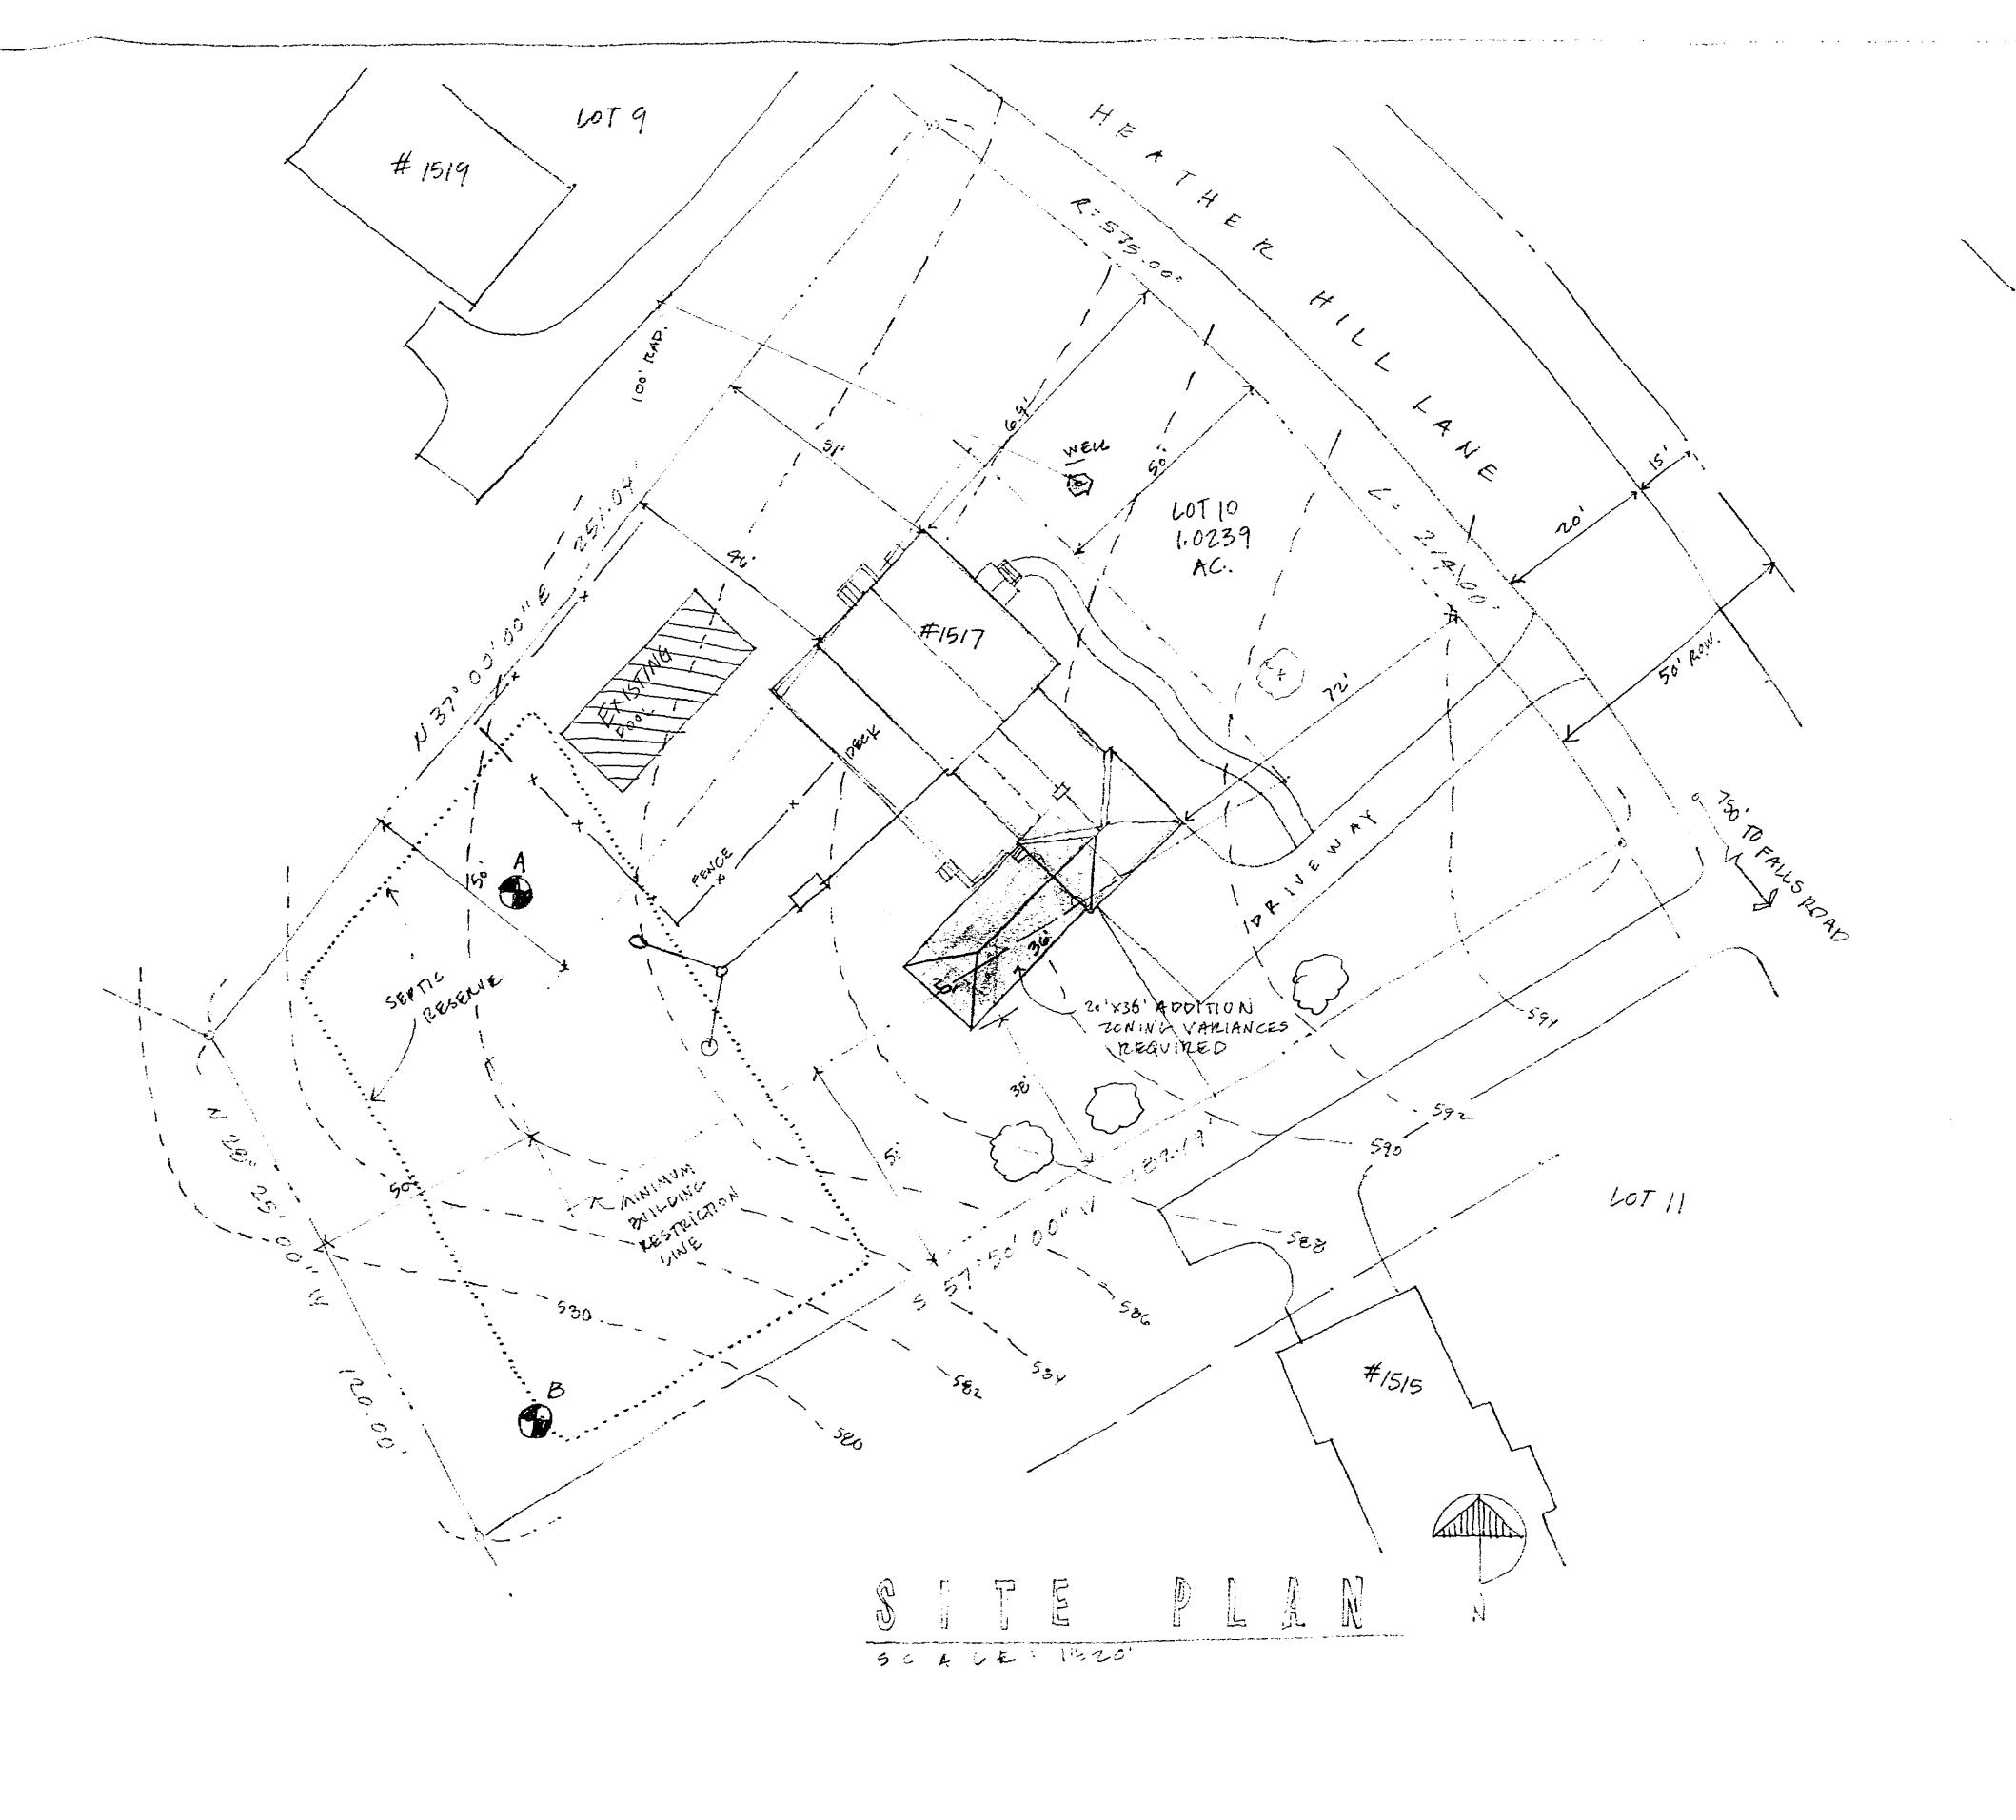

'PLAN TO ACCOMPANY VARIANCE HEARING'

91-214-A

ZONE RC 5

MILLIAM J. ANDERSON

HVStees under declaration of trust, 8/1/85

MR.+ MRS. JEFFERY HIGDON

1 PHEASANT RUN COURT

TIMONINM, MD 21093

OT NO. 10 HEATHER HILL 3th ELECTION DISTRICT BALTIMORE COUNTY, MD. COUNCILMANIC DISTRICT - 3

SCHEMATIC DRAWINGS SCALE: AS NOTED DATE: 8/9/90

PAUL J. CORMAN, ALA 306 UNDERWOOD CT. BACTIMORE, MD 21212

PROPOSED ADDITION TO: 1517 HEATHER HILL LANE, BALTO. COUNTY, MD. FOR: HIGDON RESIDENCE

A-1

ARCHITECT